

NOTE:
B1 - 500mm ROUNDED RC BASE
B2 - 1200mm ROUNDED RC BASE
C2 - 100mm S15 GALVANISED STEEL COLUMN


FOR INFORMATION

CITY ENGINEER / CLIENT	REG. NO.	DATE
------------------------	----------	------

A,B,C, /	BEFORE TENDER	A,B,C, /	AFTER TENDER
TO /	REVISION	TO /	REVISION
Z /	AS BUILT	Z /	AS BUILT

DATE	INITIAL	REV	REVISION DESCRIPTION
2020/02/19	ZVR	A	ISSUE FOR INFORMATION
2020/10/30	TS	B	FOUNDATION UPDATED
2020/11/07	TS	C	BASIS OBTAINED
2020/11/12	TS	D	BASIS AND STRIP FOOTING ADDED
2020/11/24	TS	E	COLUMNS AND STRIP FOOTING ADDED

COPYRIGHT OF THIS DESIGN AND DRAWINGS IS RESERVED. SCALED DIMENSIONS ARE INDICATED. ALL DIMENSIONS AND LEVELS TO BE VERIFIED ON SITE IMMEDIATELY. ALL BUILDING WORK TO BE IN COMPLIANCE WITH NATIONAL BUILDING STANDARDS, SOUTH AFRICAN NATIONAL STANDARDS AND LOCAL AUTHORITY BY-LAWS.

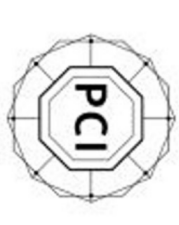

POWER CONSULTANCY
INTERNATIONAL

IN COLLABORATION WITH



GROUND FLOOR FOUNDATION: EXISTING OFFICE PARK #2 AND GROUND FLOOR: POWER ELIZABETH 6046 / TEL: 041 - 555 2200 / www.power.co.za

UHFH


CONVERSION OF EXISTING CLINIC TO OFFICES, ALICE

FOUNDATION LAYOUT AND DETAILS

ENGINEER/TECHNOLOGIST	REG. NO.	DATE
-----------------------	----------	------

SCALE	AS SHOWN	DESIGNED	AS
DATE	FEBRUARY 2025	DRAWN	ZVR
PAPER SIZE	A0	CHECKED	NMB
PROJECT No.	PCI P0000	CLIENT PROJECT No.	-
BARA 25005			

DRAWING NUMBER	REVISION
PCI : P0000/000/S/001	E
BARA : 25005/00/20/001	

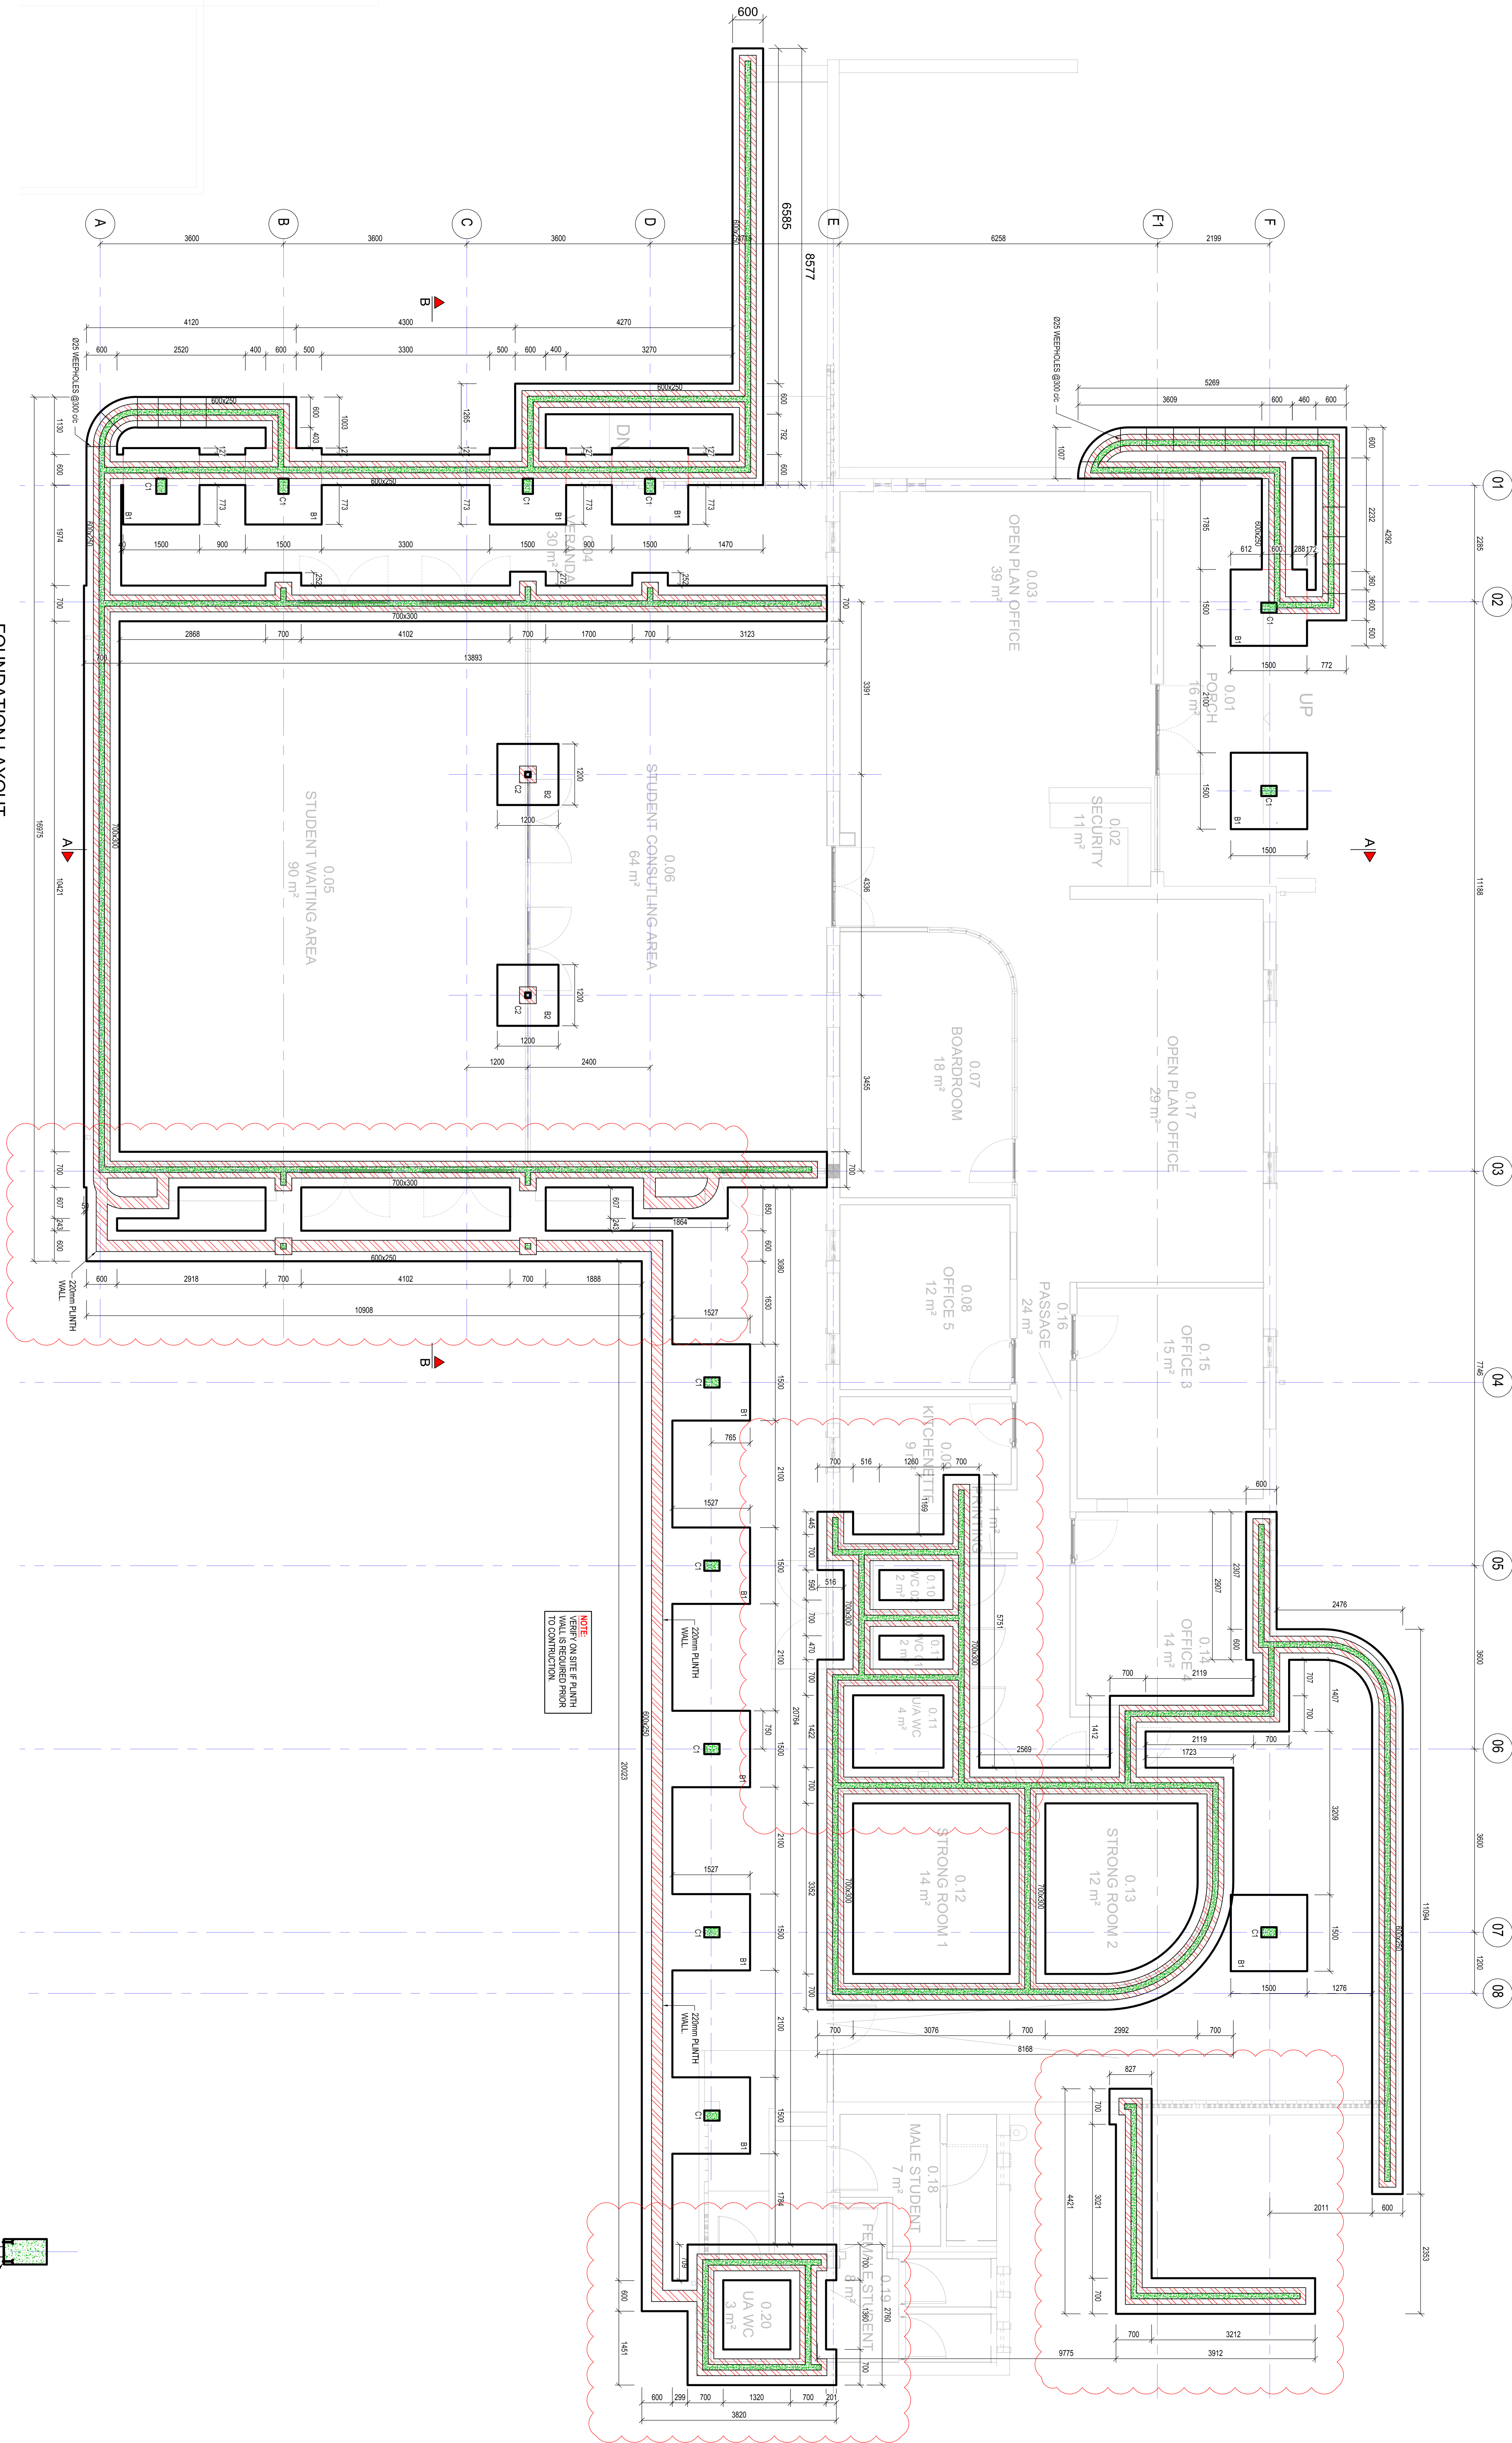

FOUNDATION LAYOUT
SCALE 1:20

TYPICAL FOUNDATION STEP DETAIL
SCALE 1:25

ISOLATION JOINT

60mm PAVING ON 20mm SAND BEDDING

PLINTH WALL DETAIL
SCALE 1:20

BASEPLATE DETAIL
SCALE 1:5

BEARING PLATE DETAIL
SCALE 1:5

TYPICAL DETAIL
SCALE 1:25

FOUNDATION DETAIL
SCALE 1:25

FOUNDATION DETAIL
SCALE 1:25

