

FOR INFORMATION


CITY ENGINEER / CLIENT	REG. NO.	DATE
------------------------	----------	------

AMENDMENT'S CODE	
A.B.C. / BEFORE TENDER	A. BY CLIENT
TO / TENDER DRAWING	B. BY ARCHITECT
0.1.2. / AFTER TENDER	C. BY ELECTRICAL
Z / AS BUILT	D. BY PC
	E. BY OTHER ()

DATE	INITIAL	REV	REVISION DESCRIPTION
2025/10/31	TS	A	ISSUE FOR INFORMATION
2025/11/07	TS	B	BASES AND COLUMNS OMITTED
2025/11/12	TS	C	BASES AND COLUMNS ADDED
2025/11/24	TS	D	SLAB AND COLUMNS ADDED

COPYRIGHT OF THIS DESIGN AND DRAWINGS IS RESERVED. SCALED DIMENSIONS ARE VALID. ALL DIMENSIONS & LEVELS TO BE VERIFIED ON SITE IMMEDIATELY. ALL BUILDING WORK TO BE IN COMPLIANCE WITH NATIONAL BUILDING REGULATIONS, SOUTH AFRICAN NATIONAL STANDARDS, AND LOCAL AUTHORITY BY-LAWS.

ENGINEERING CONSULTANT: CIVIL & STRUCTURAL

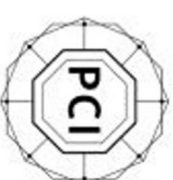

POWER CONSULTANCY
INTERNATIONAL
IN COLLABORATION WITH



STATUS: IN CASE OF DISCREPANCIES BETWEEN DIFFERENT DRAWINGS, THE DRAWING SHALL PREVAIL OVER THE SPECIFICATIONS, AND THE SPECIFICATIONS SHALL PREVAIL OVER THE CONTRACT DOCUMENTS.
GREENWICH, PORT ELIZABETH 6046 / TEL: 041 455 2205 / WWW.PCI.CO.ZA

CLIENT

UFH

PROJECT

CONVERSION OF EXISTING CLINIC
TO OFFICES, ALICE

DRAWING TITLE


SECTIONS

APPROVED BY PCI

ENGINEER/TECHNOLOGIST	REG. NO.	DATE
-----------------------	----------	------


SCALE	AS SHOWN	DESIGNED	AS
DATE	OCTOBER 2025	DRAWN	TS
PAPER SIZE	A0	CHECKED	NMB
PROJECT NO.	PCI P0000	CLIENT PROJECT NO.	-
BARA 25055			

DRAWINGS NUMBER	REVISION
PCI : P0000/00/S/004	D
BARA : 25055/00/20/004	

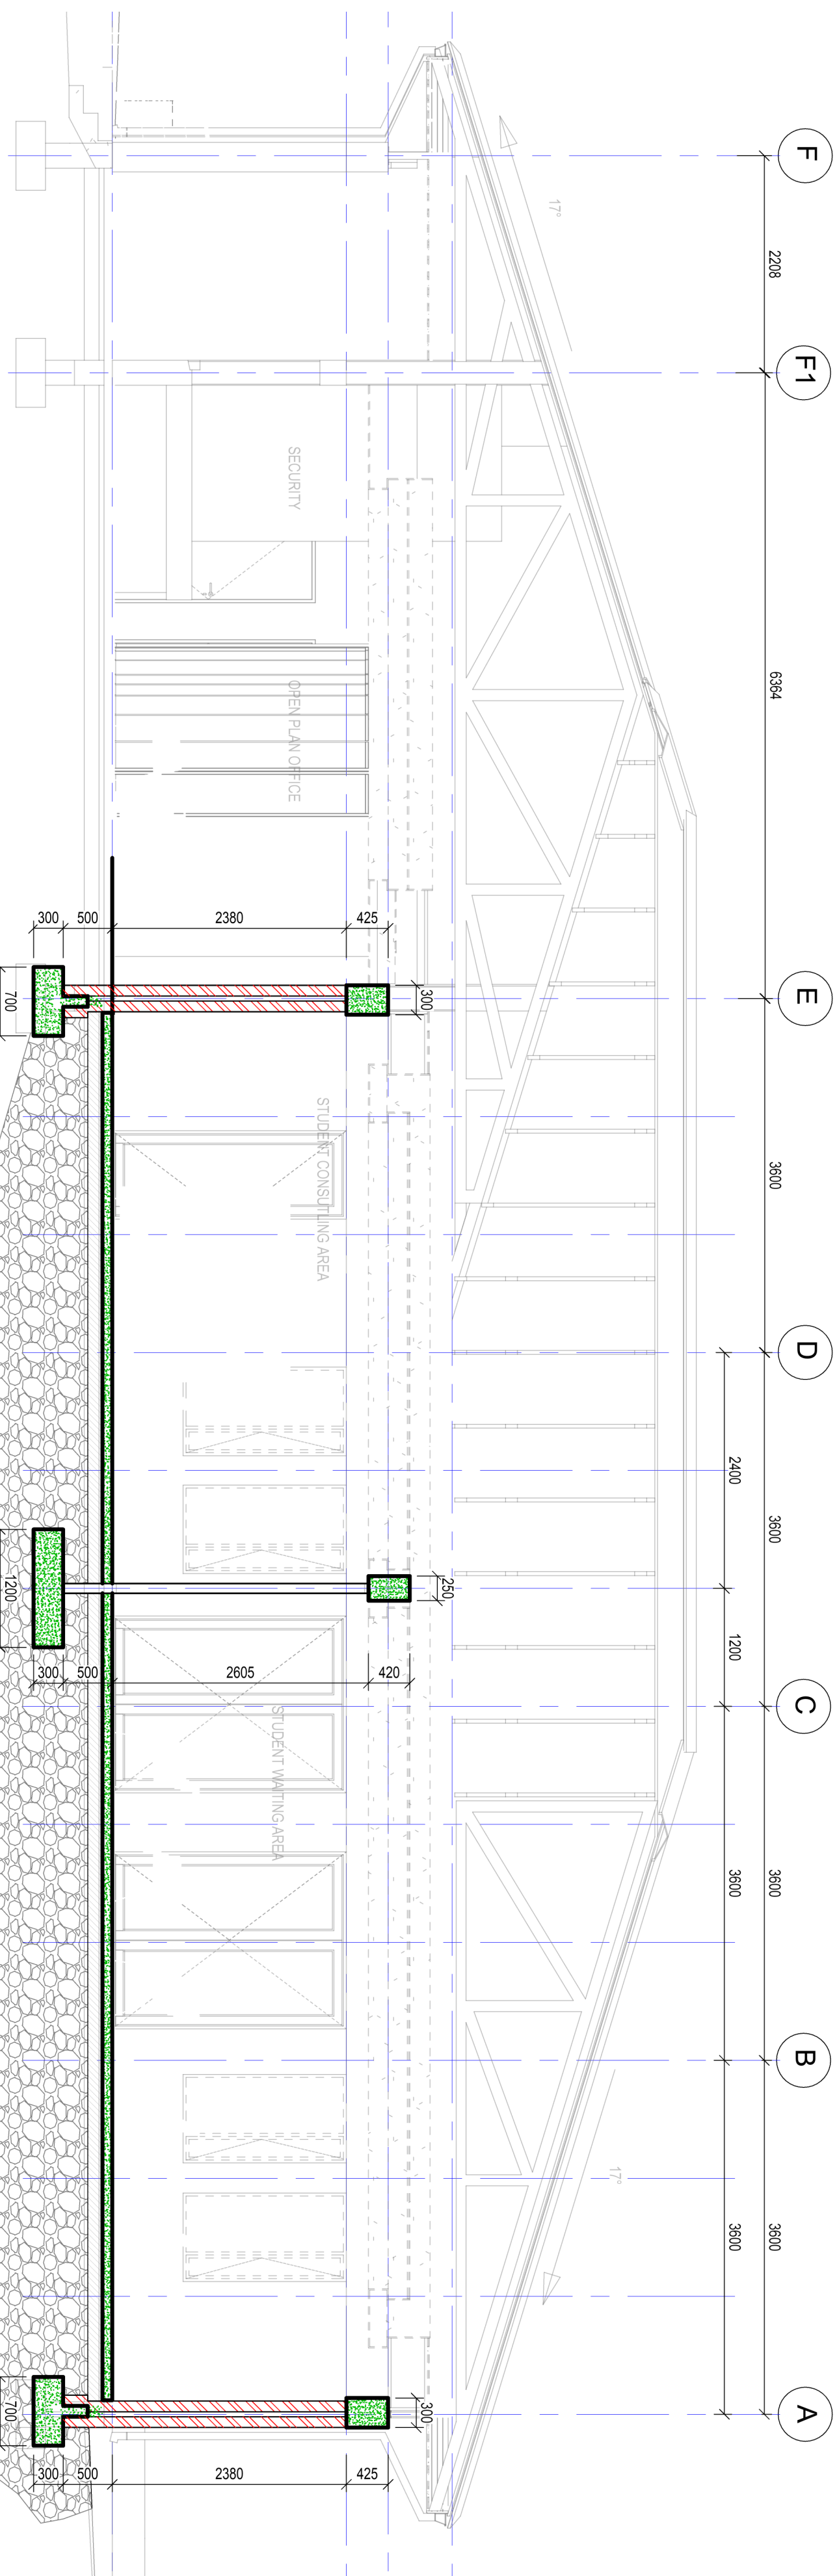

SECTION A-A

SCALE 1:50

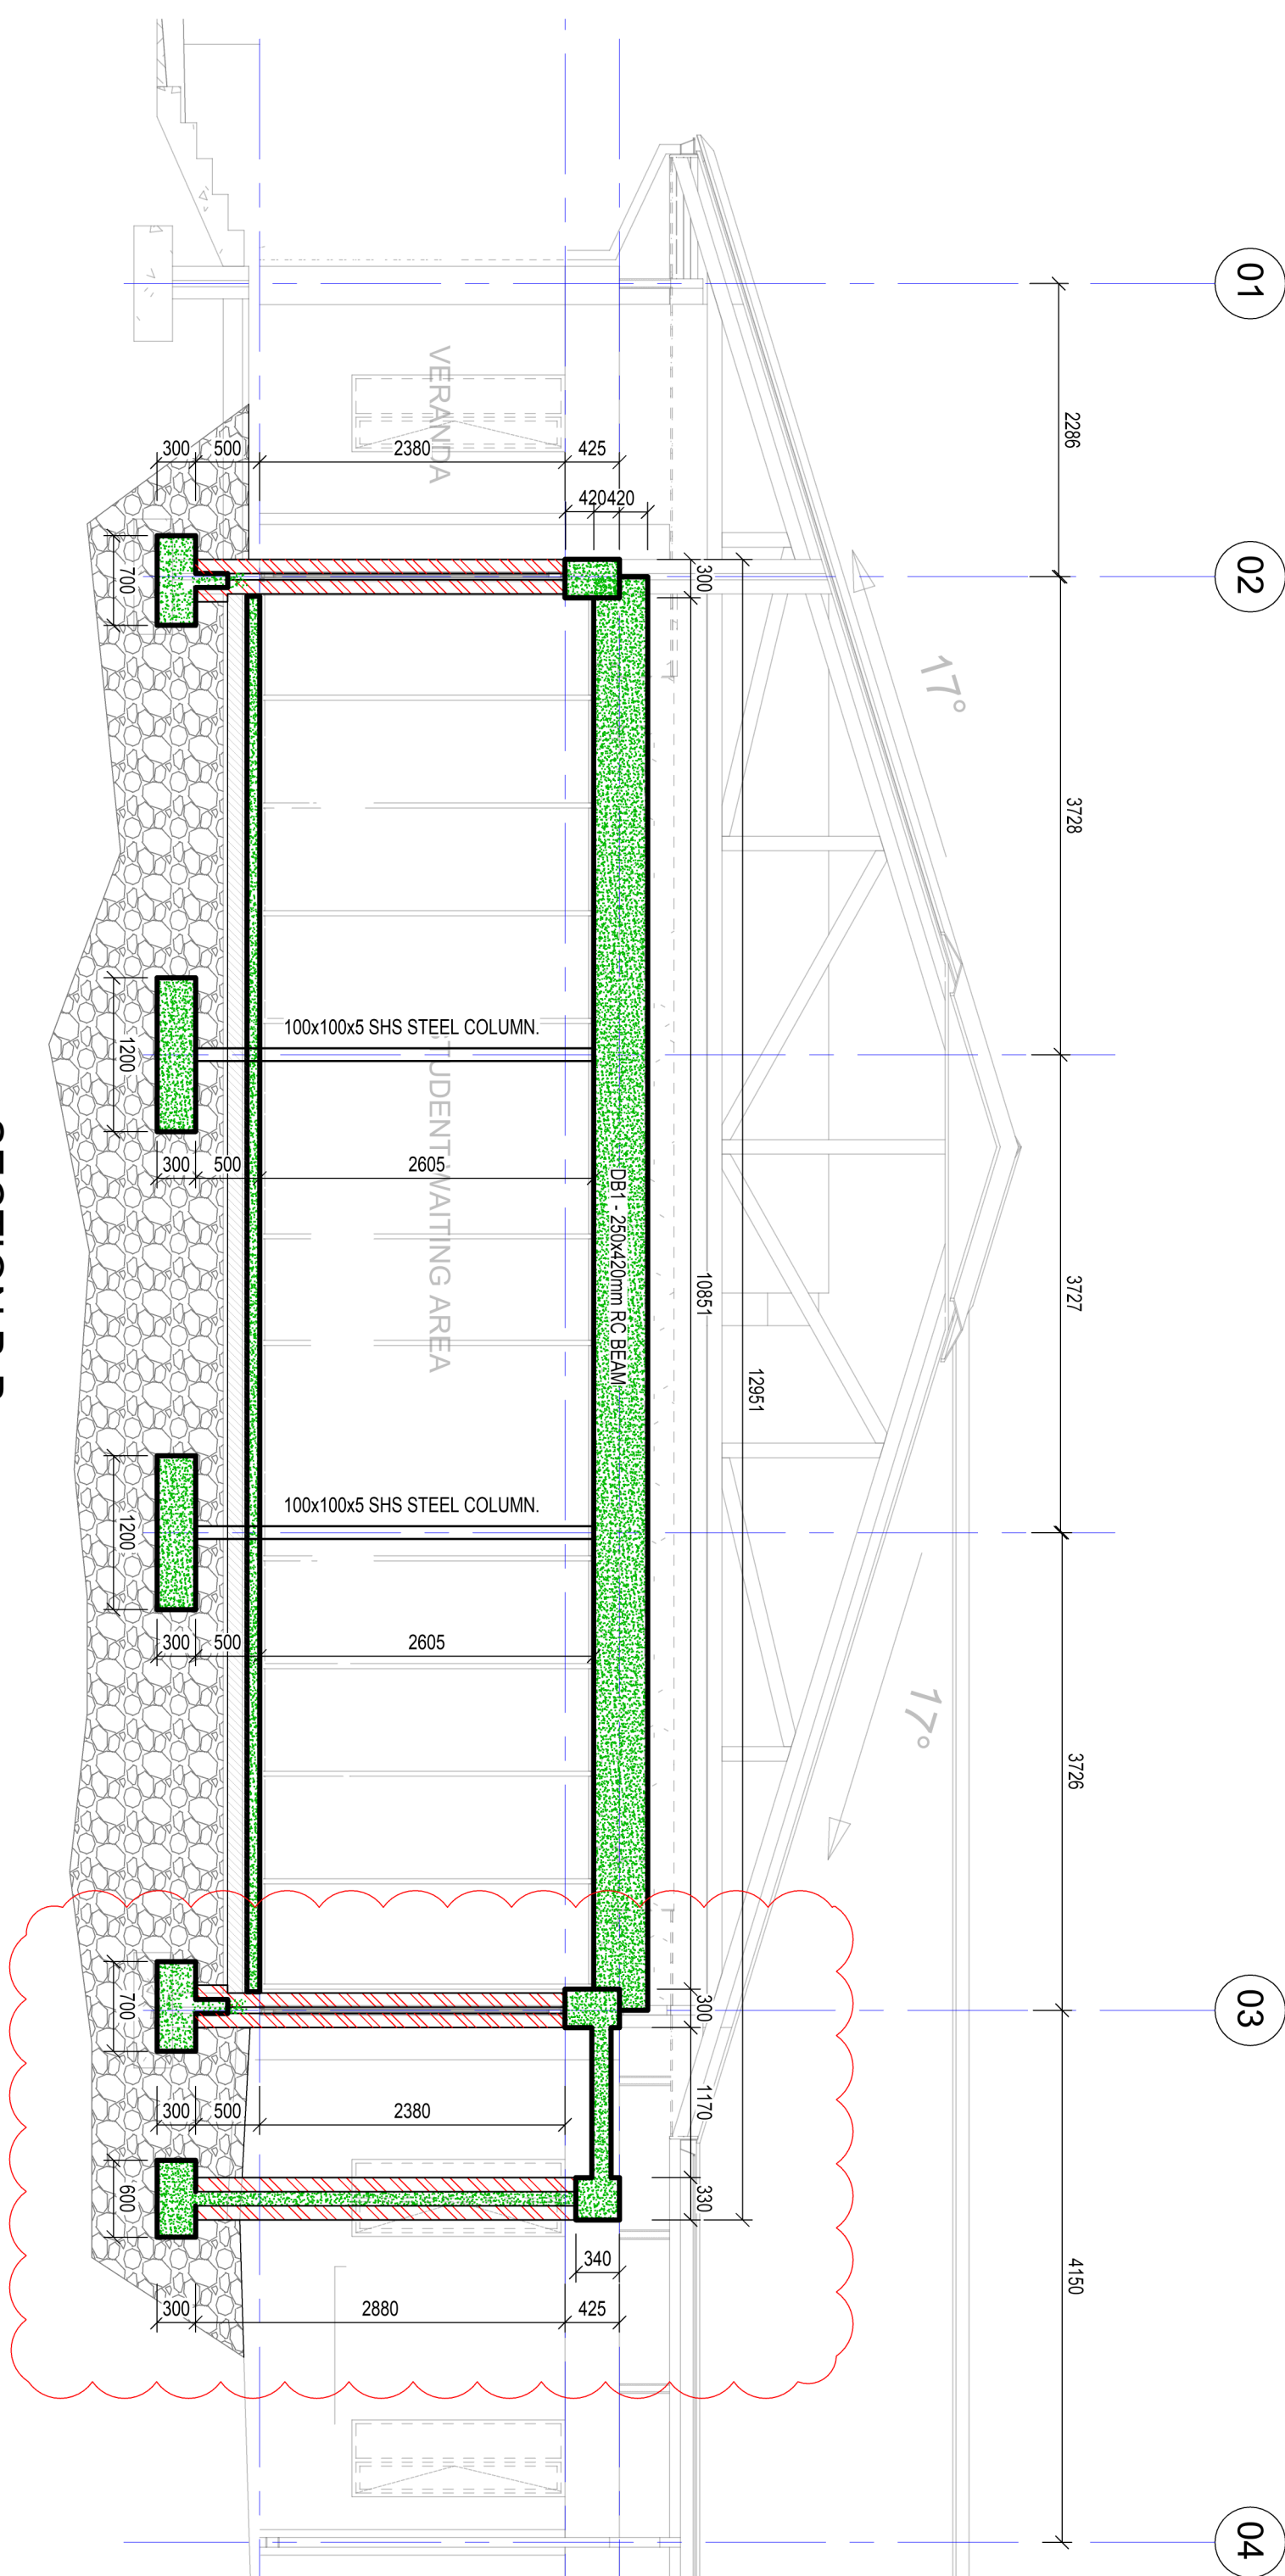

SECTION B-B

SCALE 1:50