

NOTES / LEGEND

NOTE:
B1 - 150mm ROUNDED RC BASE
B2 - 120mm ROUNDED RC BASE
C2 - 100mm SIS GALVANISED STEEL COLUMN

PROJECT STATUS

FOR INFORMATION


CITY ENGINEER / CLIENT	REG. NO.	DATE
------------------------	----------	------

AMENDMENTS CODE		REVISION DESCRIPTION
A,B,C,J	BEFORE TENDER	A,B BY CLIENT
T	TENDER DRAWING	T BY PROJECT
0.1,2	AFTER TENDER	0.1 BY ELECTRICAL, 0.2 BY CIVIL
Z	AS BUILT	(E BY OTHER)

DATE	INITIAL	REV	REVISION DESCRIPTION
2020/02/19	ZVR	A	ISSUE FOR INFORMATION
2020/10/30	TS	B	FOUNDATION UPDATED
2020/11/07	TS	C	BASIS OBTAINED
2020/11/12	TS	D	BASIS AND STRAP FOOTING ADDED
2020/11/24	TS	E	COLUMNS AND STRAP FOOTING ADDED

COPYRIGHT OF THIS DESIGN AND DRAWINGS IS RESERVED. SCALED DIMENSIONS ARE INDICATED. ALL DIMENSIONS & LEVELS TO BE REFERRED ON SITE IMMEDIATELY. ALL BUILDING WORK TO BE IN COMPLIANCE WITH NATIONAL BUILDING STANDARDS, SOUTH AFRICAN NATIONAL STANDARDS AND LOCAL AUTHORITY BY-LAWS.

ENGINEERING CONSULTANT: CIVIL & STRUCTURAL

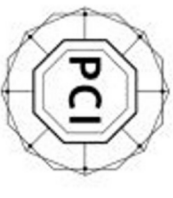

POWER CONSULTANCY
INTERNATIONAL

IN COLLABORATION WITH



GROUND FLOOR FOUNDATION: EXISTING OFFICE PARK #2 AND GROUND GREENWICH'S POWER ELIZABETH 6046 / TEL: 041 - 555 2200 / www.power.co.za

CLIENT

UHF

PROJECT

CONVERSION OF EXISTING CLINIC
TO OFFICES, ALICE

DRAWING TITLE

FOUNDATION LAYOUT AND
DETAILS


APPROVED BY PCI

ENGINEER/TECHNOLOGIST	REG. NO.	DATE
-----------------------	----------	------

SCALE	AS SHOWN	DESIGNED	AS
DATE	FEBRUARY 2025	DRAWN	ZVR
PAPER SIZE	A0	CHECKED	NMB
PROJECT No.	PCI P0000	CLIENT PROJECT No.	-
BARA 25005			

DRAWING NUMBER	REVISION
PCI : P0000/000/S/001	E
BARA : 25005/00/20/001	

- 230mm Wide brick walls
- 270mm Wide brick walls
- 330mm Wide brick walls

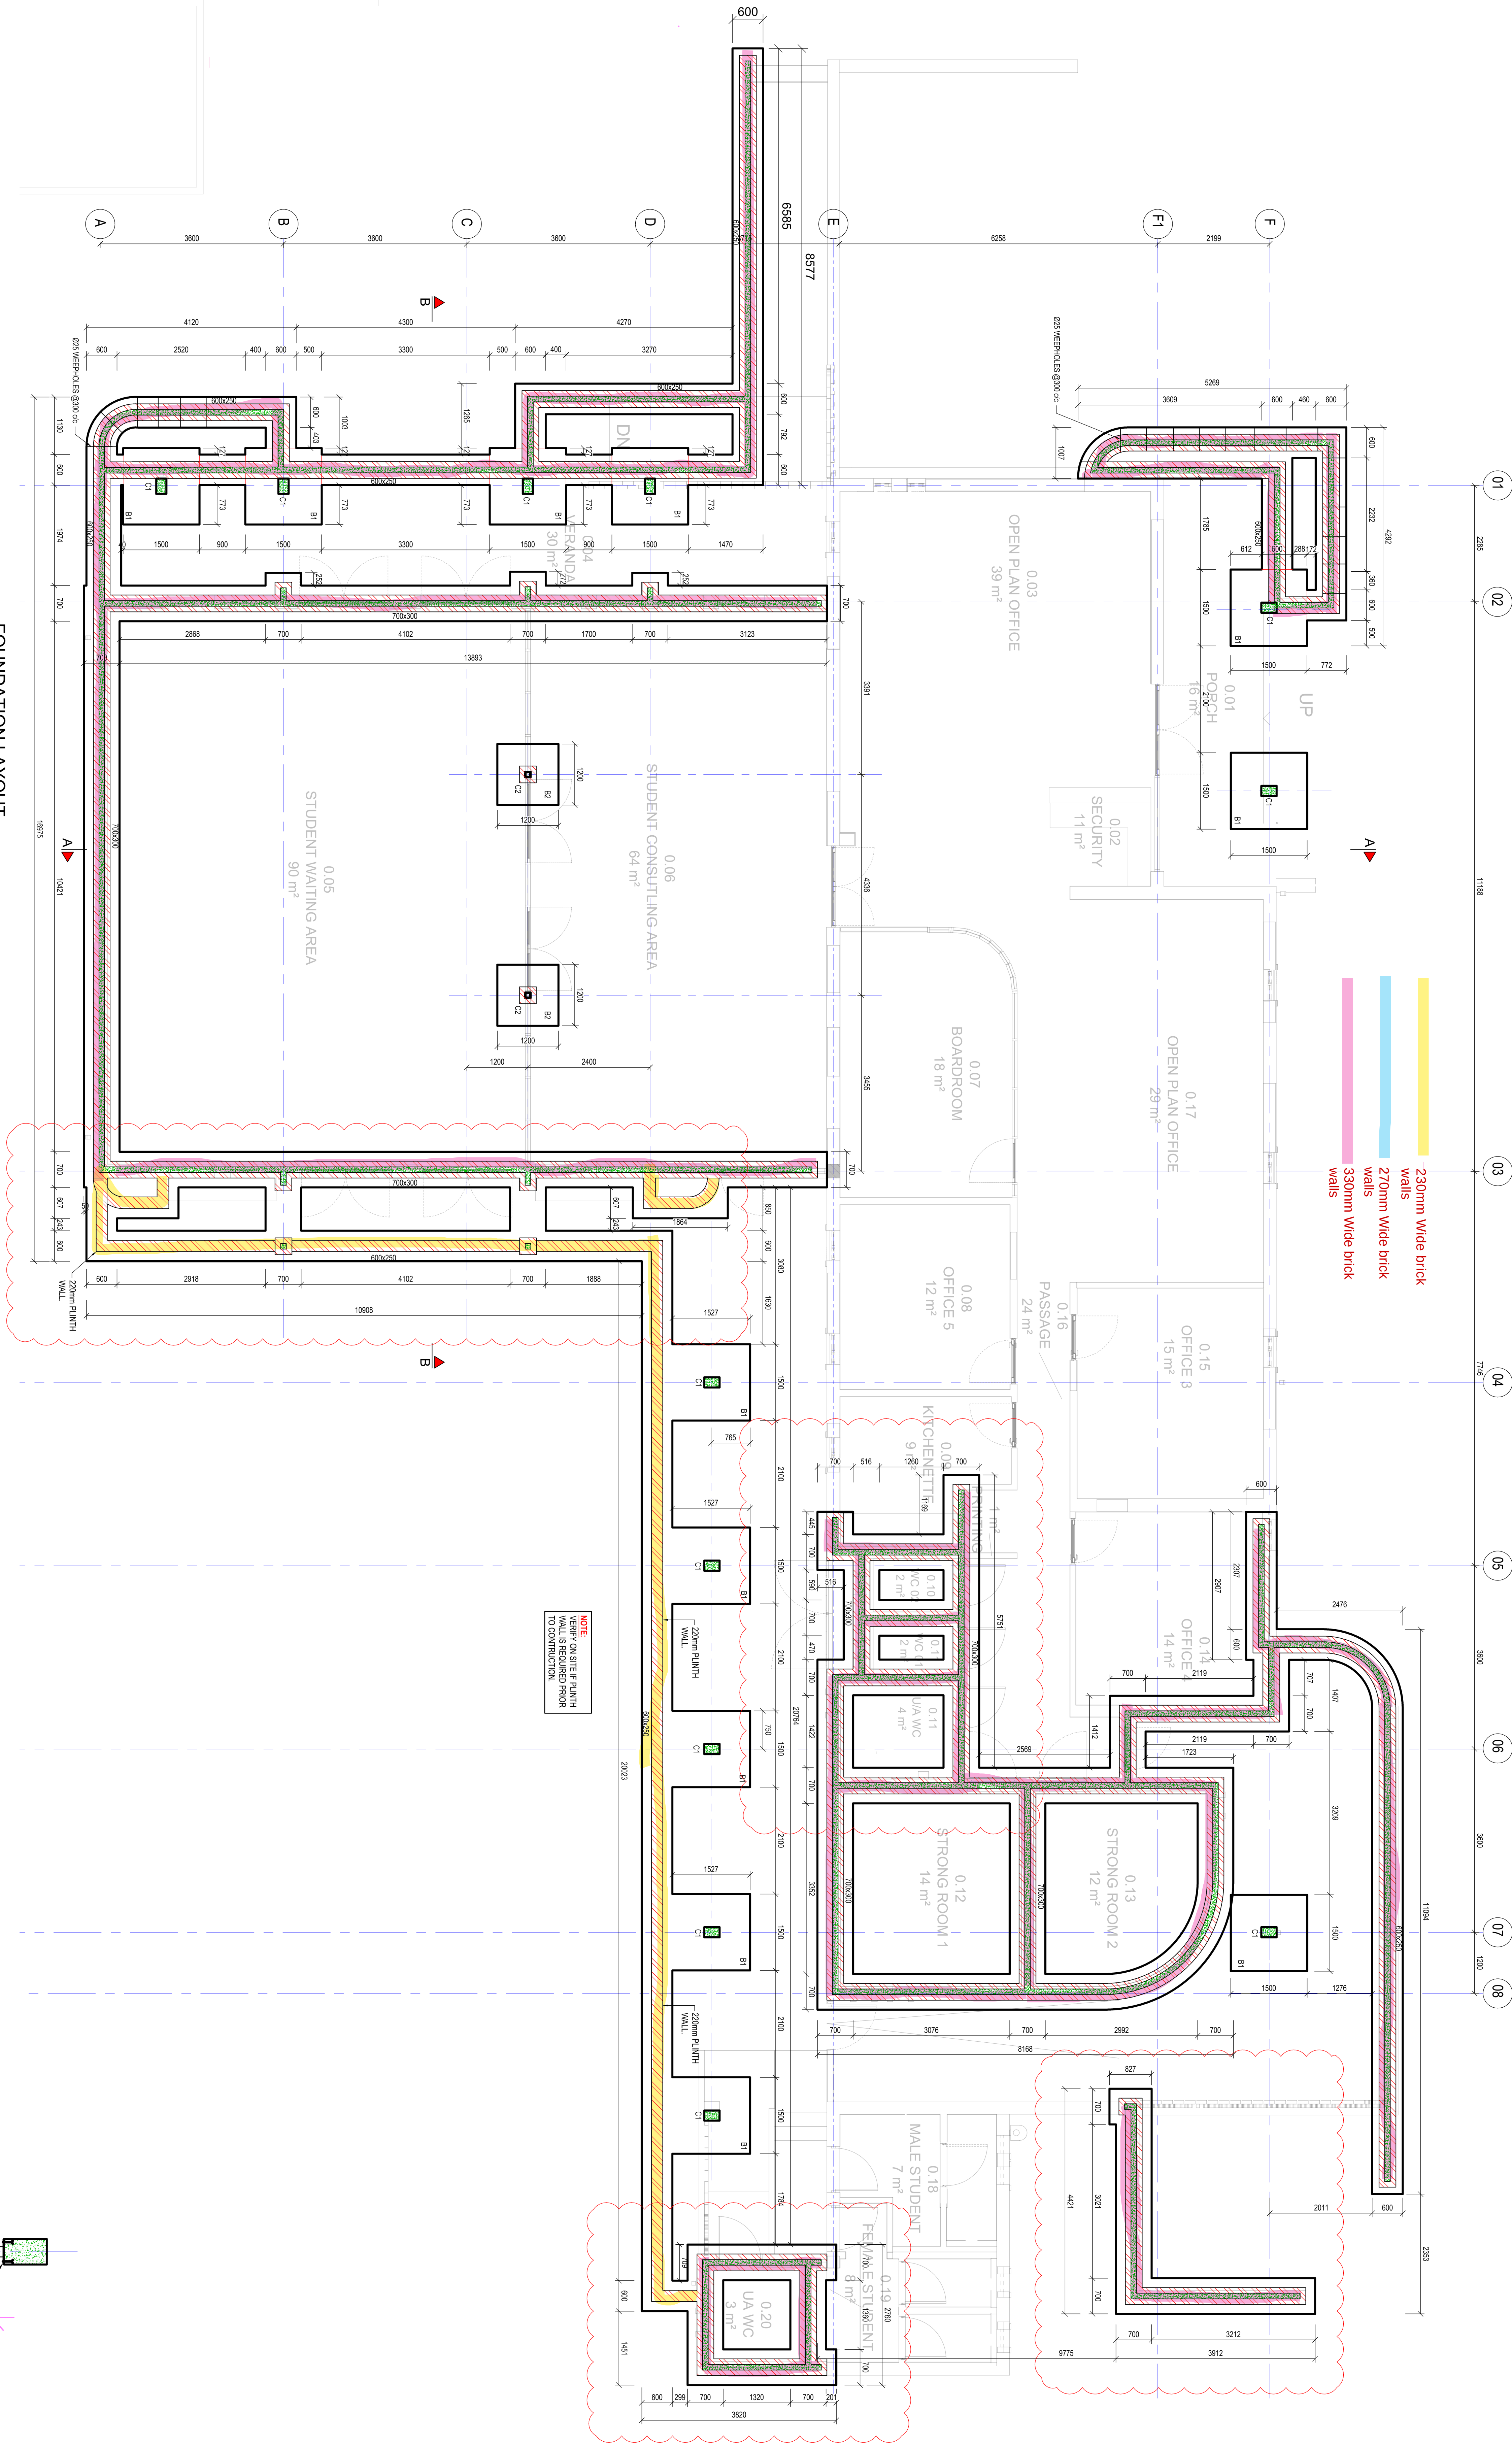

0 10 20 30 40 50 60 70 80 90 100